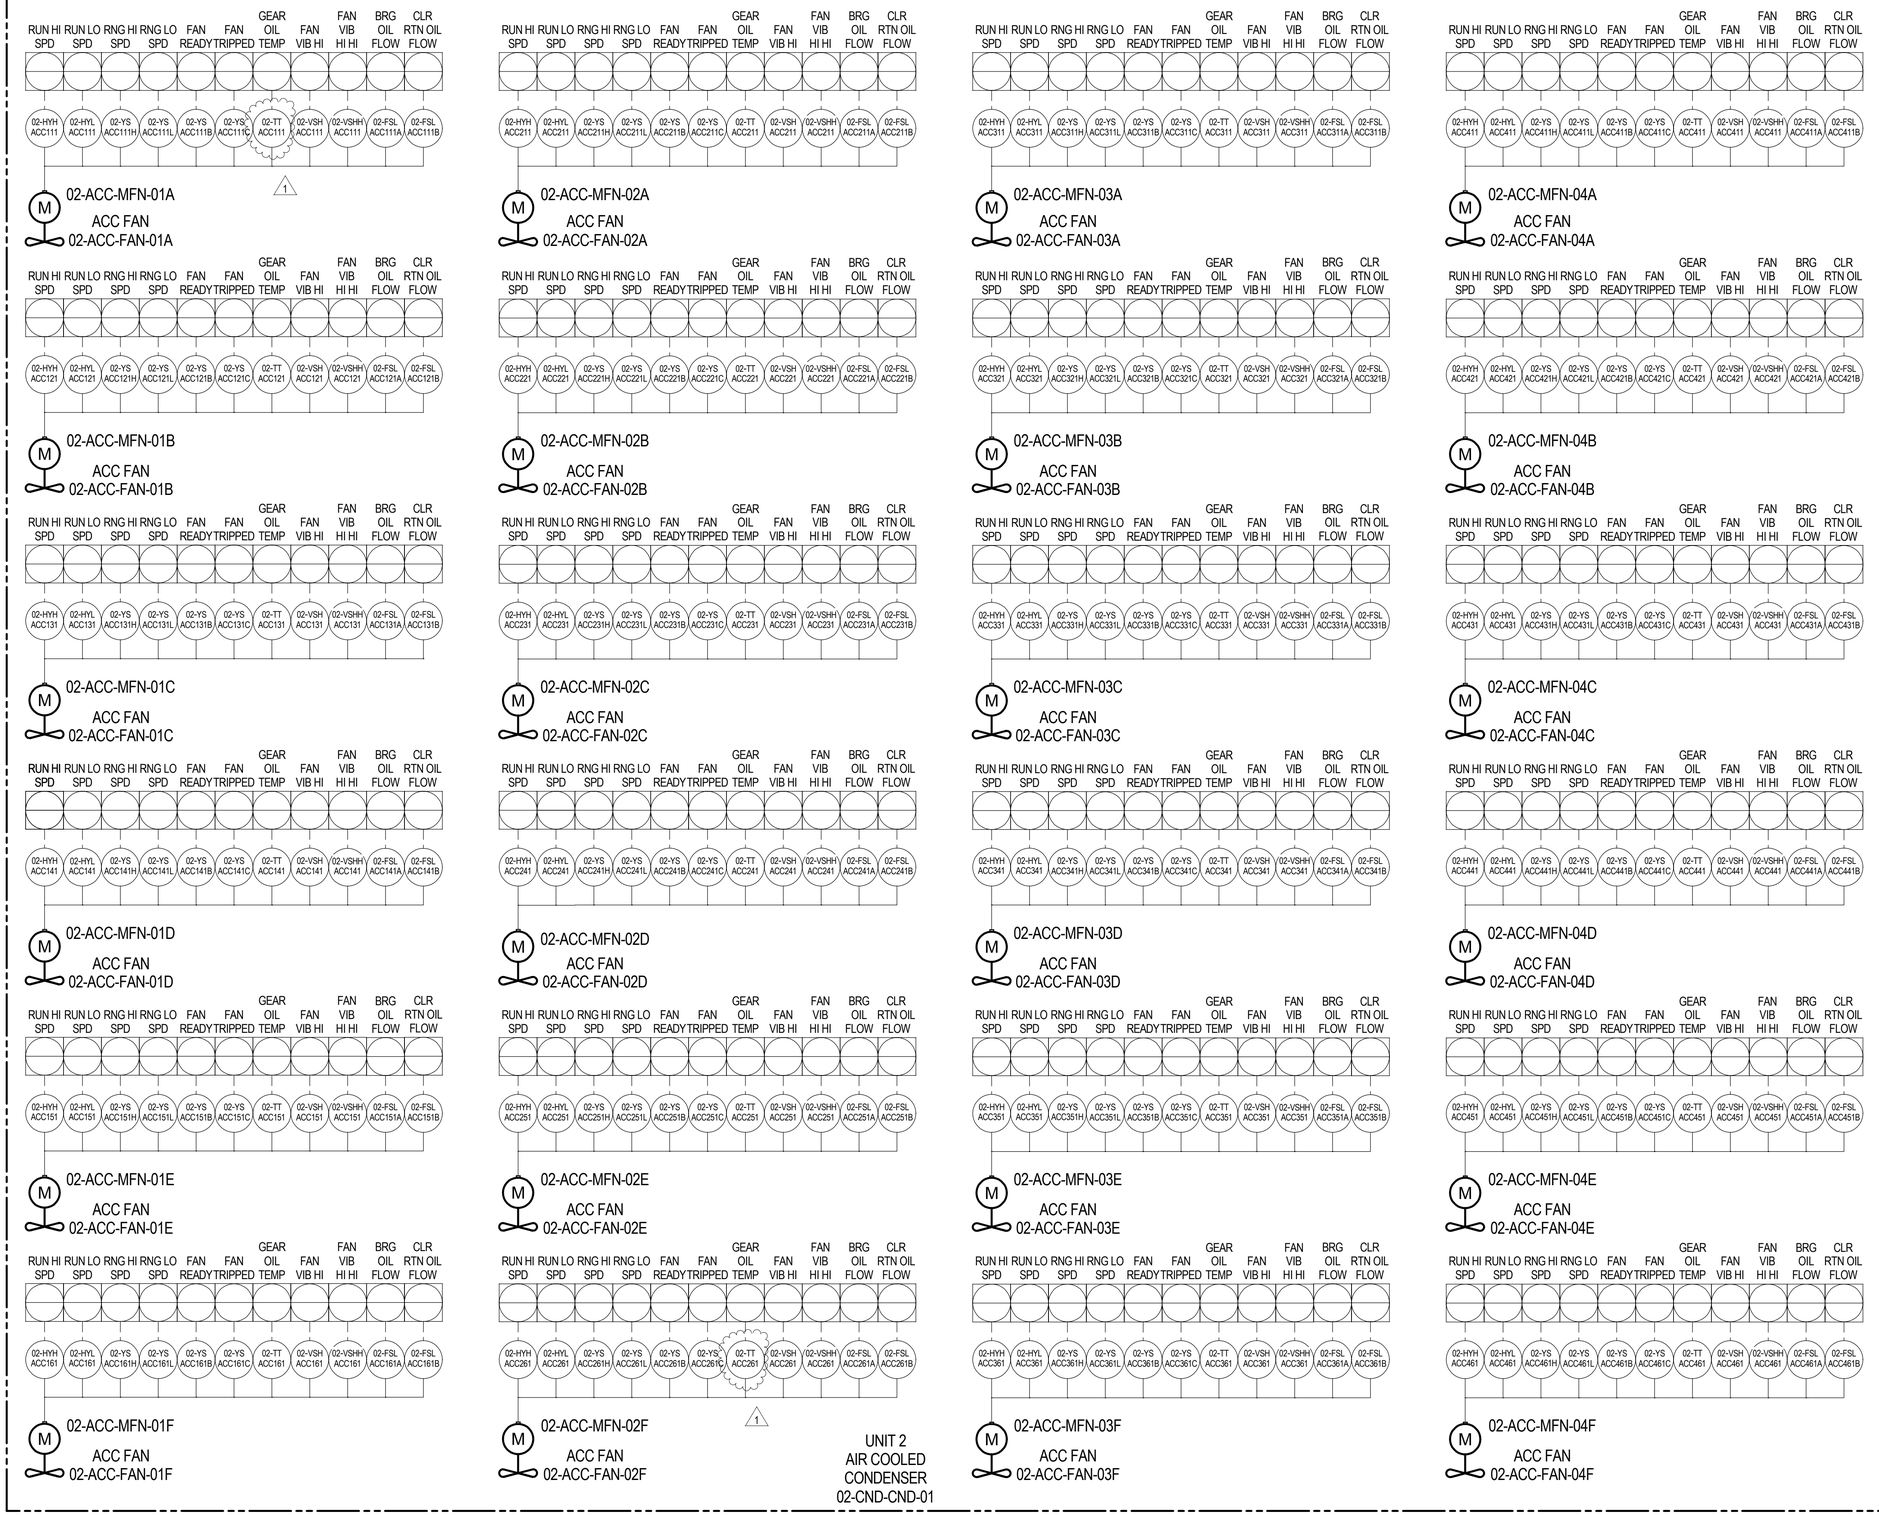

LEGEND

START-UP CODE
ACC2.2- ALL

REV	DESIGN BY	CHECKED BY	DATE
1	CONFORMED TO CONSTRUCTION RECORDS		
	K. GALLAGHER	T. SHINO	01-17-22
0	ISSUED FOR CONSTRUCTION		
	K. HUDSON	D. WHEAT	05-06-20

JACKSON GENERATION, LLC.
JACKSON GENERATION

Kiewit
ILLINOIS DESIGN FIRM REGISTRATION NUMBER 184004213-0006

Kevin.Gallagher
Digitally signed by Kevin.Gallagher
DN: CN=Kevin.Gallagher, OU=Employees, OU=Users, OU=Kiewit, DC=KIEWITPLAZA, DC=com
Date: 2022.01.21 08:52:23-06'00'

LICENSED PROFESSIONAL ENGINEER
KEVIN GALLAGHER
062.073087
OF ILLINOIS
EXPIRES: 11/30/23

PIPING AND INSTRUMENTATION DIAGRAM
CND - CONDENSATE

ENGINEER/DESIGN ORIGINATOR	K. HUDSON
LEAD ENG	P. NOVOGORATZ
ENG MGR	T. SHINO
PROJ MGR	F. BUSCH

DRAWING NUMBER
20023894-PD-055B